


TENANT LEGEND	
[Blue diagonal lines]	METRO NORTH
[Light blue diagonal lines]	METRO NORTH POLICE
[Blue cross-hatch]	CDOT (CONNECTICUT DEPT. OF TRANSPORTATION)
[Yellow diagonal lines]	AMTRAK
[Yellow dotted]	NEW HAVEN PARKING AUTHORITY (NHFA)
[Orange dotted]	NEW HAVEN UNION NEWS
[Green dotted]	URBITRAN
[Green diagonal lines]	WEBSTER BANK
[Green cross-hatch]	AVIS
[Green diagonal lines]	GREYHOUND
[Green diagonal lines]	VACANT
[Purple dotted]	SBARRO
[Purple dotted]	DUNKIN DONUTS (SEEMA)
[Purple dotted]	SUBWAY (SEEMA)
[Purple dotted]	BOARD OF EDUCATION ON SERVICES FOR THE BLIND

BASEMENT LEVEL PLAN
TENANT INFORMATION
 SCALE: 3/8" = 1'-0"

NOTE:
 REFER TO DRAWING A-2.10 FOR
 ROOM FINISH SCHEDULE.

AS-BUILT RECORD DRAWINGS
UNION STATION TRANSPORTATION CENTER
 (YEAR 2008)
 NEW HAVEN CONNECTICUT

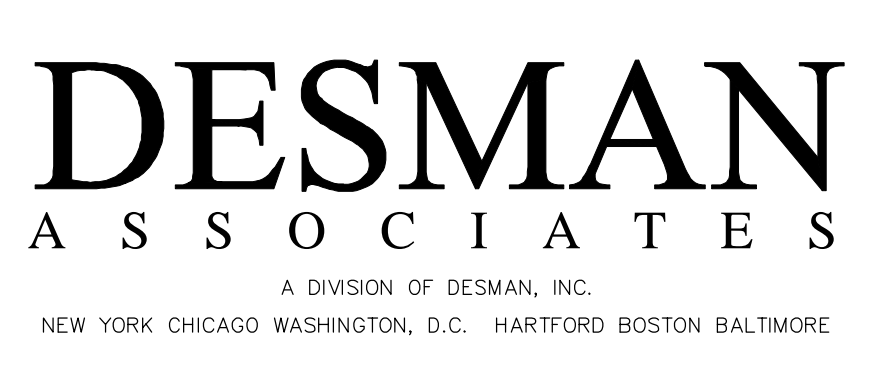

NO.	DATE	BY

DRAWING NO. A-2.21
 SCALE: AS NOTED
 DATE: MARCH 2008
 PROJECT NO. 40-9501.03-2
 NHFA NO. 06-002 C
 DESIGN DRAWN CH/MD
 EP-G. W.E.G.

Copyright © 2008 Desman, Inc. All rights reserved.
 No part of these documents may be reproduced
 in any form or by any means without written
 permission from Desman, Inc.

