

BASEMENT LEVEL ROOM NO. PLAN
 SCALE: 3/32" = 1'-0"

NOTE:
 REFER TO DRAWING A-1.0 FOR
 ROOM FINISH SCHEDULE.

AS-BUILT RECORD DRAWINGS
 UNION STATION TRANSPORTATION CENTER
 (YEAR 2008)
 NEW HAVEN CONNECTICUT

DESMAN ASSOCIATES
 A DIVISION OF DESMAN, INC.
 NEW YORK CHICAGO WASHINGTON, D.C. HARTFORD BOSTON BALTIMORE


NO.	DATE	BY

DRAWING TITLE
 BASEMENT LEVEL ROOM NO. PLAN

DRAWING NO.
 A-2.2R

SCALE: AS NOTED
 DATE: MARCH 2008
 PROJECT NO: 40-0601-03-2
 NHPA NO. 06-002, C
 DESIGN DRAWN (CH/DO)
 E.P.G. W.E.G.

Copyright © 2008 Desman, Inc. All rights reserved.
 No part of these documents may be reproduced
 in any form or by any means without written
 permission from Desman, Inc.

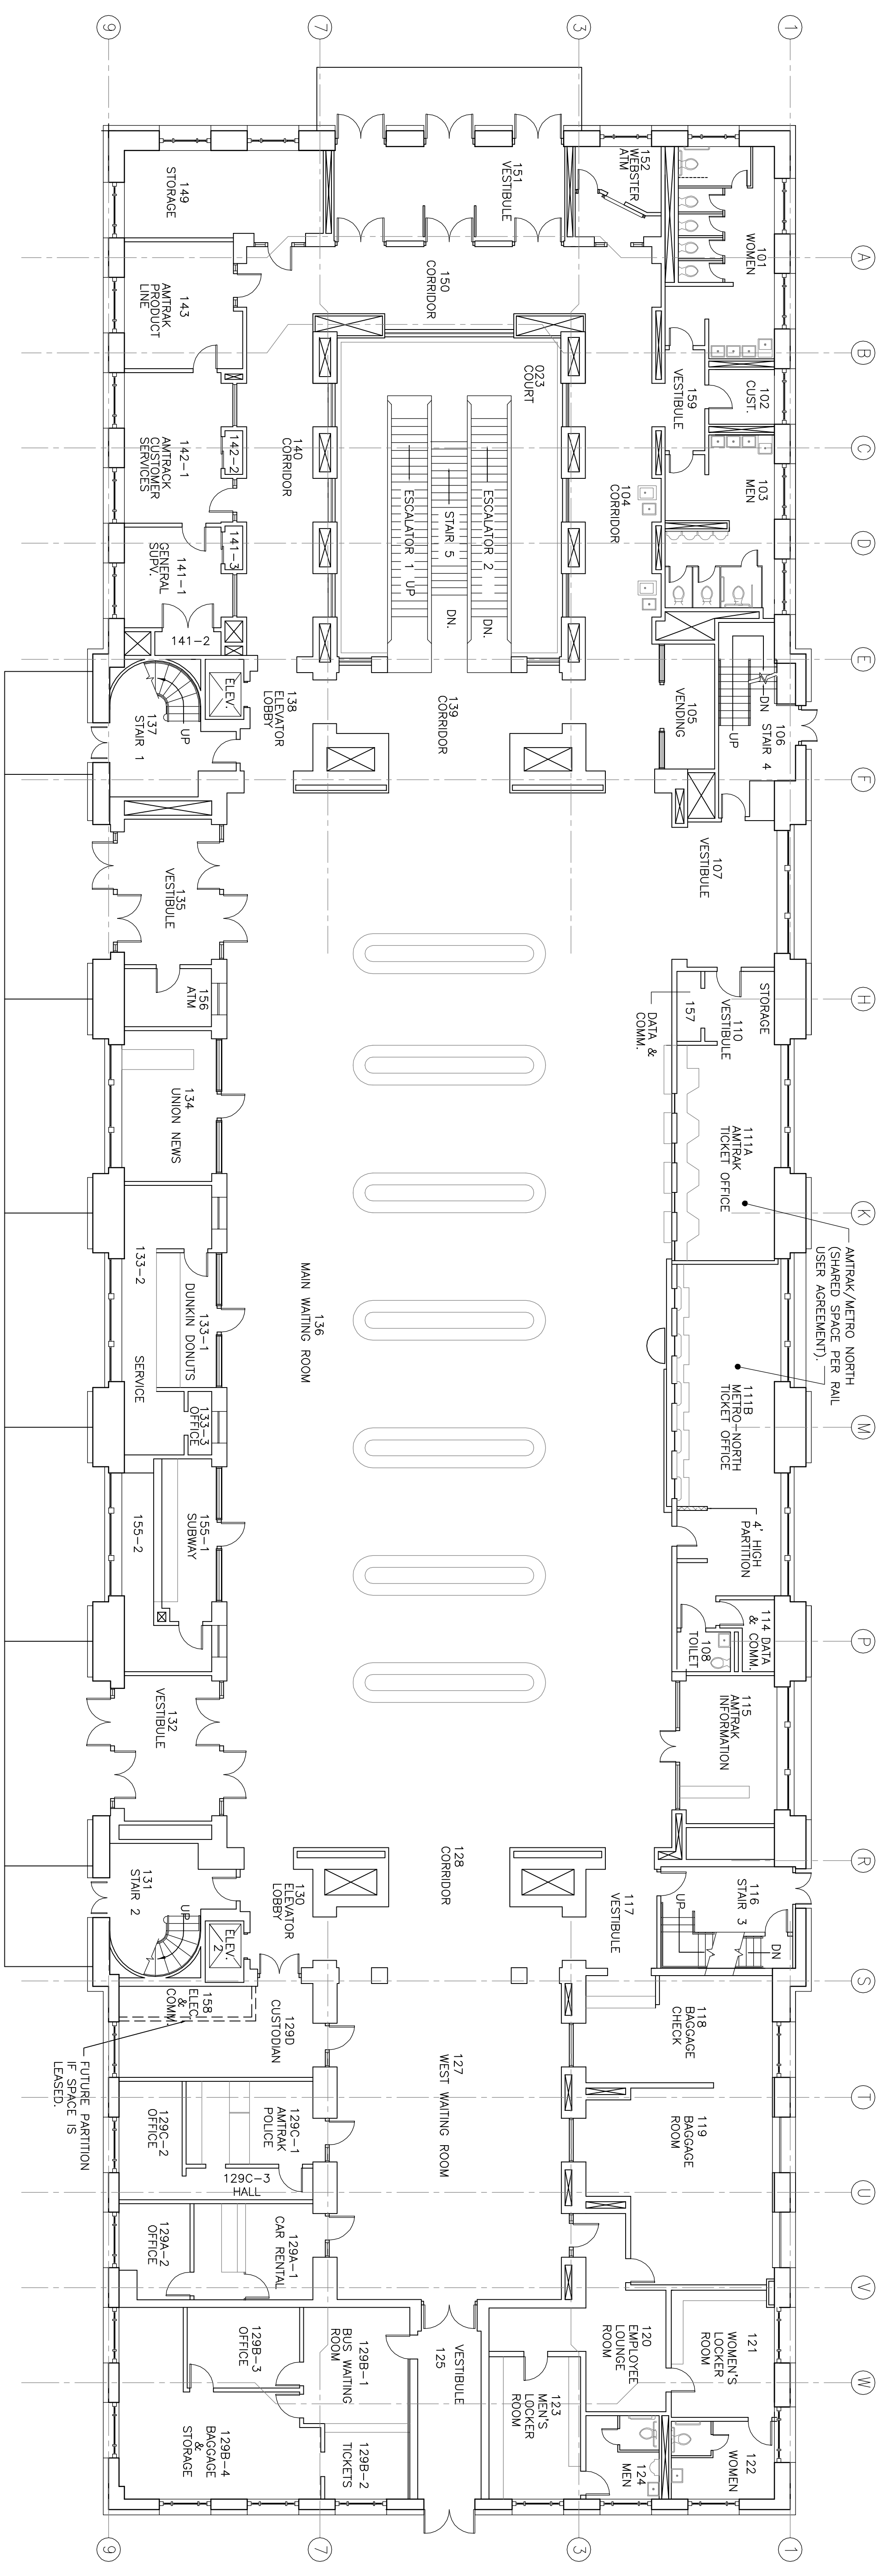

FIRST LEVEL ROOM NO. PLAN
 SCALE: 3/32" = 1'-0"

NOTE:
 REFER TO DRAWING A-2.1 FOR
 ROOM FINISH SCHEDULE.

**AS-BUILT RECORD DRAWINGS
 UNION STATION TRANSPORTATION CENTER
 (YEAR 2008)
 NEW HAVEN CONNECTICUT**




NO.	DATE	BY

DRAWING TITLE: FIRST LEVEL ROOM NO. PLAN
 DRAWING NO.: A-2.3R

SCALE: AS NOTED
 DATE: MARCH 2008
 PROJECT NO: 40-9901-03-2
 NHPA NO. 06-002 C
 DESIGN DRAWN CH/MD
 E.P.G. W.E.G.

Copyright © 2008 Desman, Inc. All rights reserved.
 No part of these documents may be reproduced
 in any form or by any means without written
 permission from Desman, Inc.

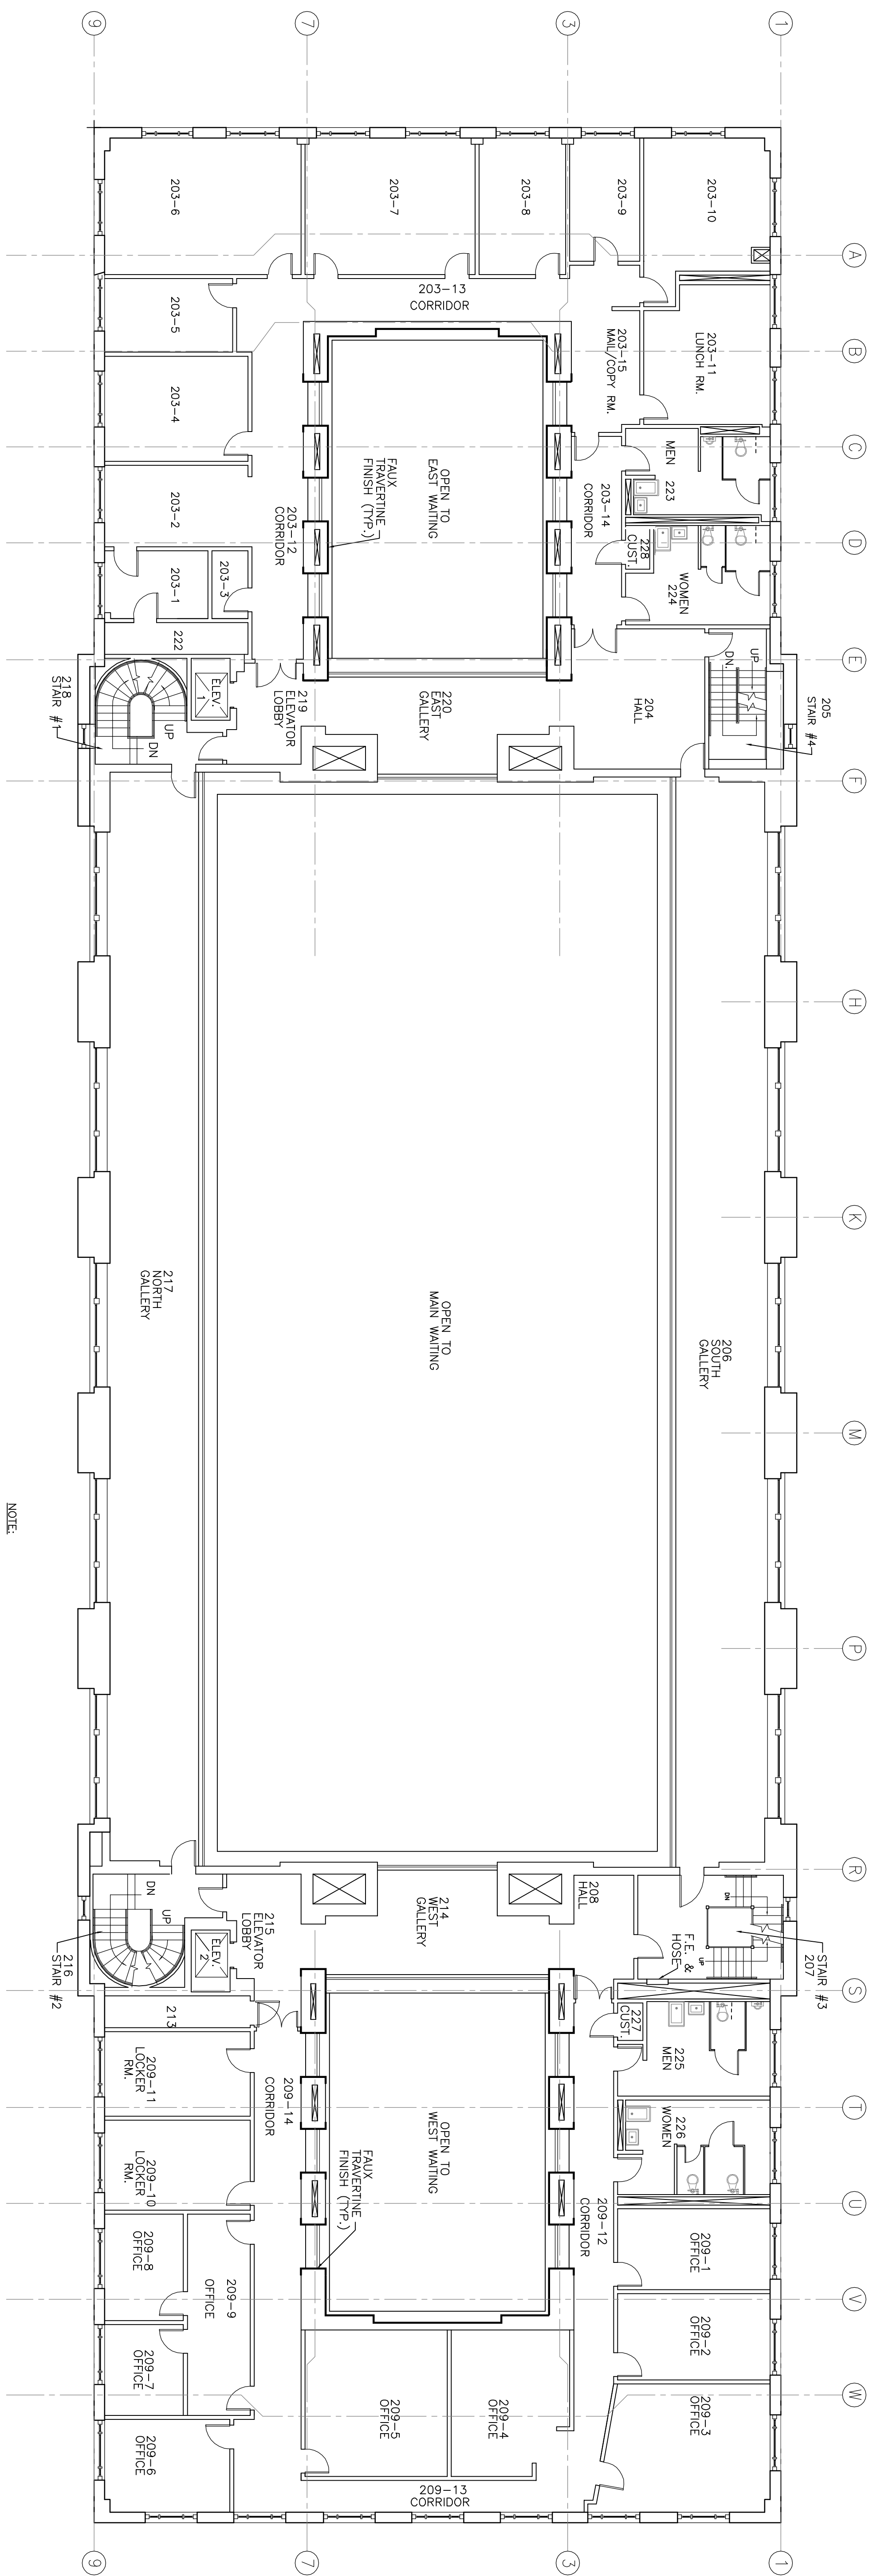

SECOND LEVEL ROOM NO. PLAN
SCALE: 3/32"=1'-0"


NOTE:
REFER TO DRAWING A-1.2 FOR
ROOM FINISH SCHEDULE.

AS-BUILT RECORD DRAWINGS
UNION STATION TRANSPORTATION CENTER
(YEAR 2008)
NEW HAVEN CONNECTICUT



DRAWING NO.		A-2.4R
SCALE:		AS NOTED
DATE:		MARCH 2008
PROJECT NO.:		40-0901.03-2
NHPA NO.:		06-002 C
DESIGN:		DRAWN CH/AD
E.P.G.:		W.E.G.
NO.	DATE	BY
REVISIONS		
DRAWING TITLE		
SECOND LEVEL ROOM NO. PLAN		

Copyright © 2008 Desman, Inc. All rights reserved. No part of these documents may be reproduced in any form or by any means without written permission from Desman, Inc.

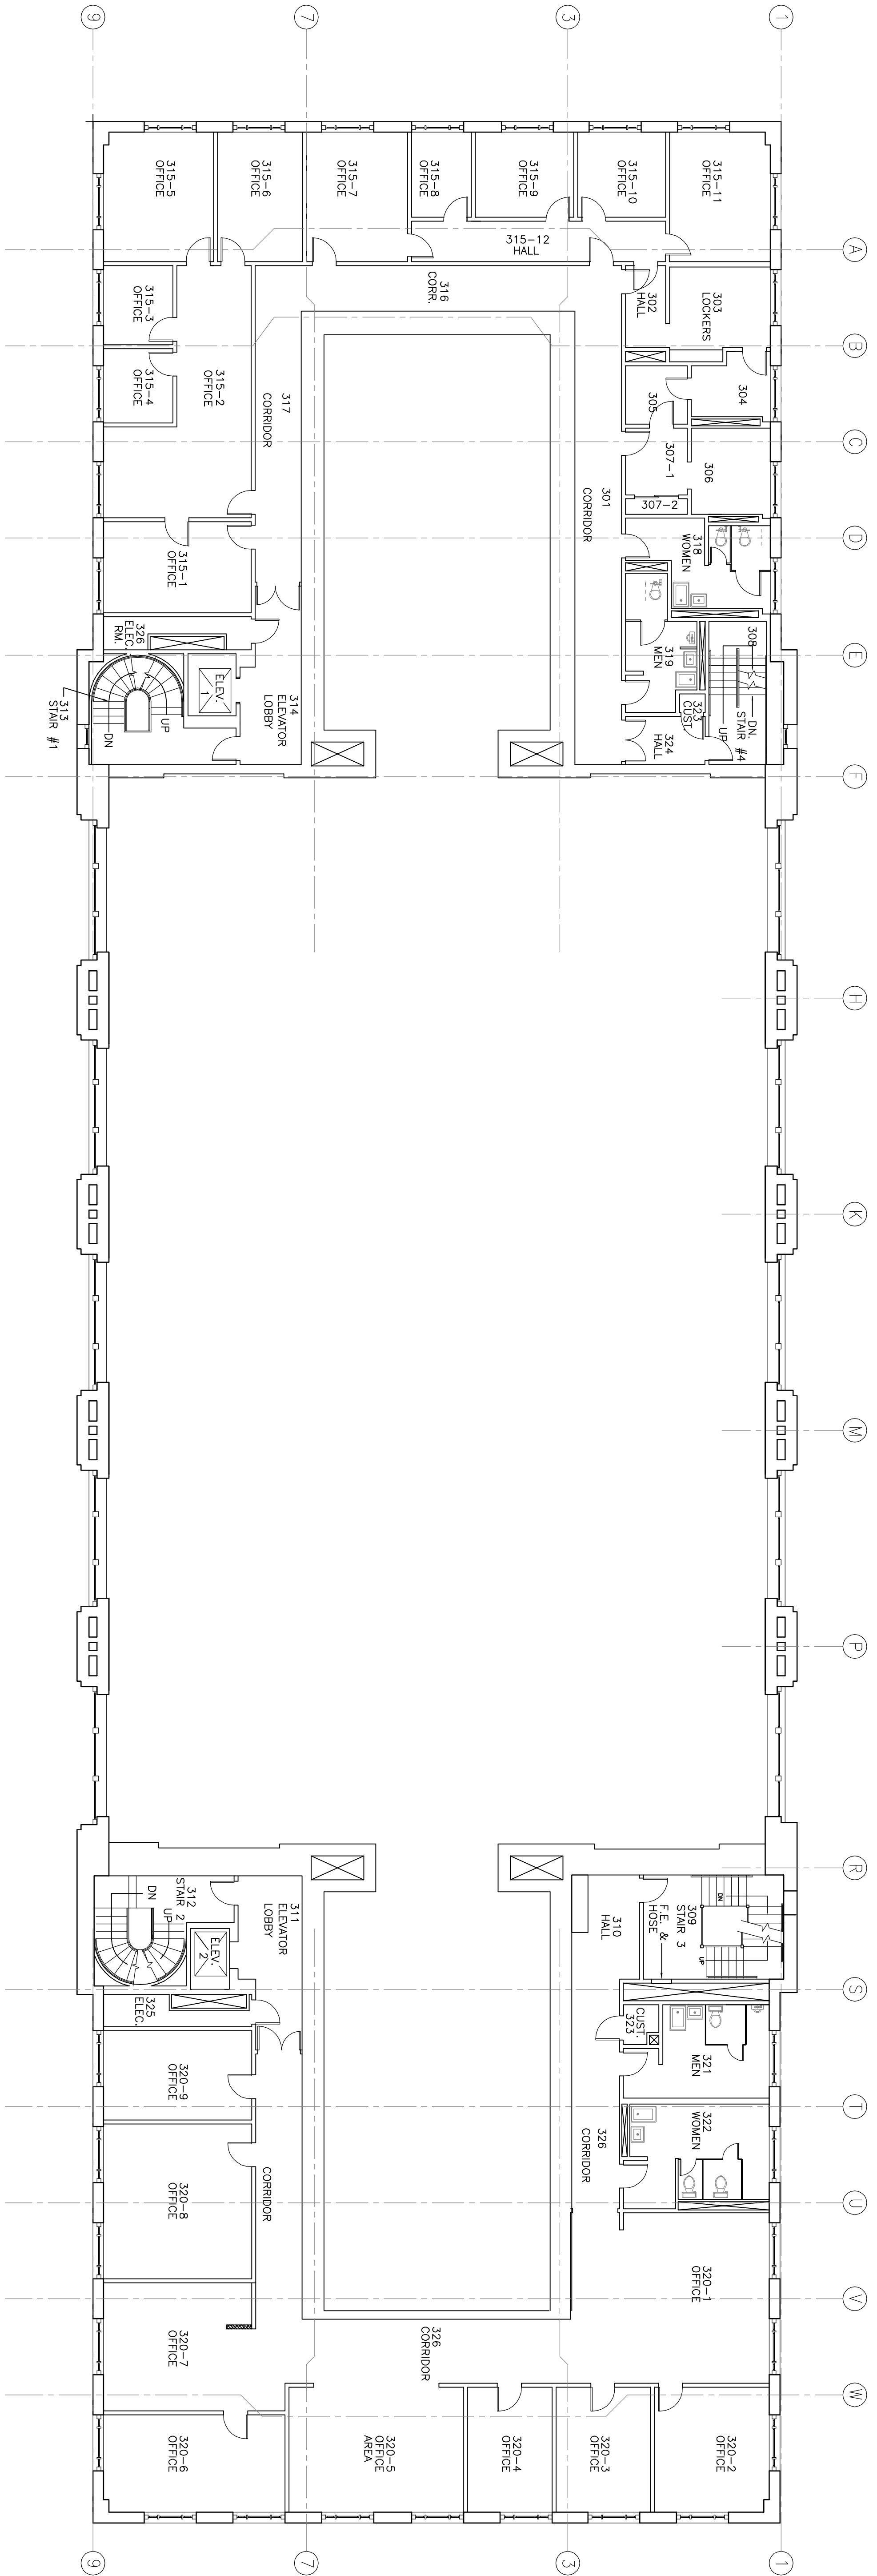


THIRD LEVEL ROOM NO. PLAN
SCALE: 3/32"=1'-0"

AS-BUILT RECORD DRAWINGS
UNION STATION TRANSPORTATION CENTER
(YEAR 2008)
NEW HAVEN CONNECTICUT

DESMAN ASSOCIATES
A DIVISION OF DESMAN, INC.
NEW YORK CHICAGO WASHINGTON, D.C. HARTFORD BOSTON BALTIMORE

DRAWING NO.		A-2.5R
SCALE:		AS NOTED
DATE:	MARCH 2008	
PROJECT NO.:	40-9901.03-2	
DESIGN:	DRAWN CH/DO	
EP-G:	W.E.G.	
NO.		DATE
BY		
REVISIONS		
DRAWING TITLE		
THIRD LEVEL ROOM NO. PLAN		


Copyright © 2008 Desman, Inc. All rights reserved.
No part of these documents may be reproduced
in any form or by any means without written
permission from Desman, Inc.

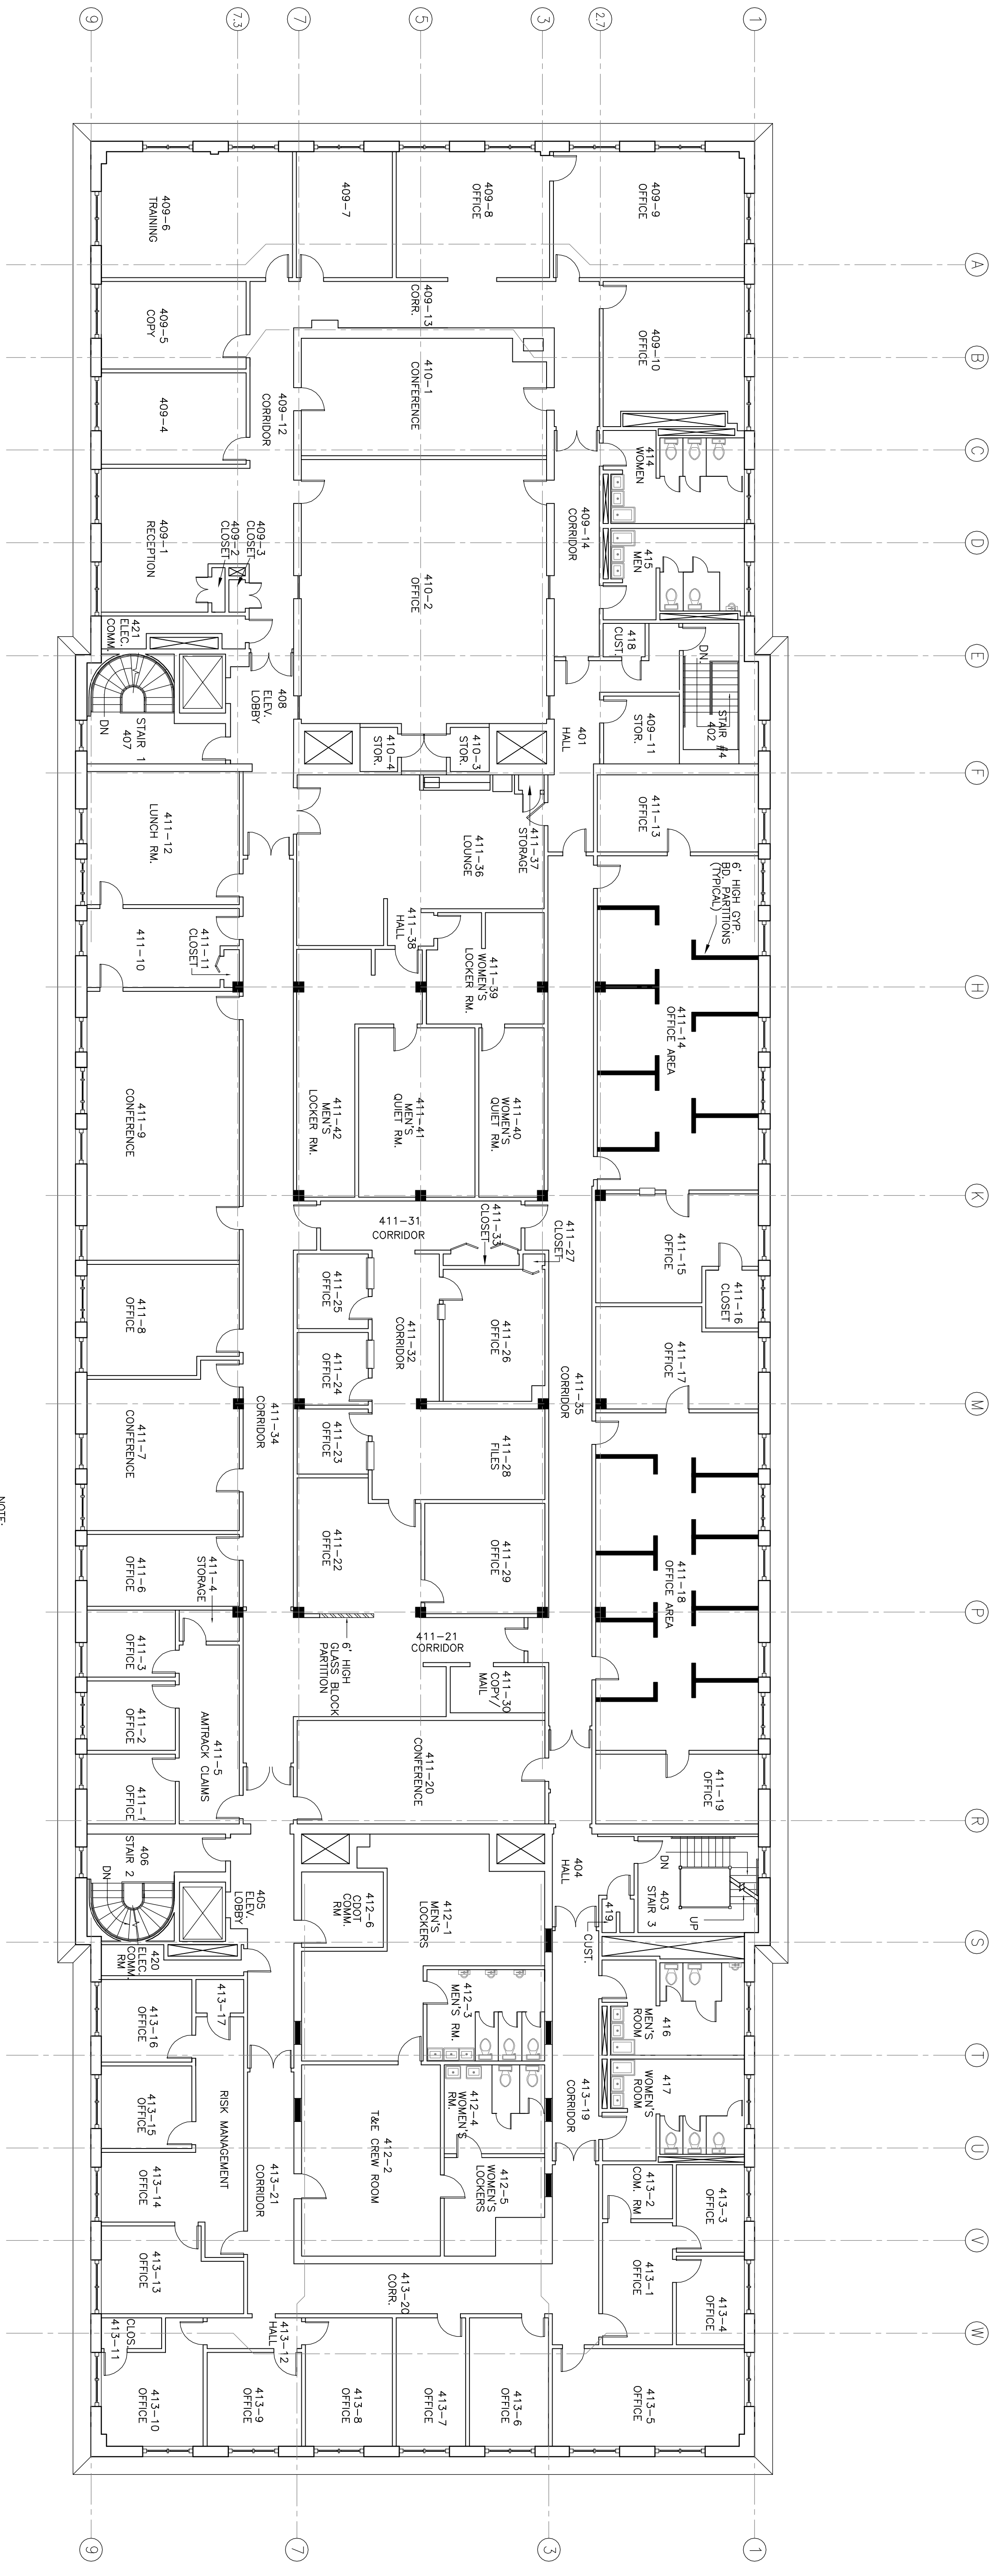

FOURTH LEVEL ROOM NO. PLAN
SCALE: 3/32"=1'-0"

NOTE:
REFER TO DRAWING A-3-4-1 AND
A-3-4-2 FOR ROOM FINISH
SCHEDULE

AS-BUILT RECORD DRAWINGS
UNION STATION TRANSPORTATION CENTER
(YEAR 2008)
NEW HAVEN CONNECTICUT

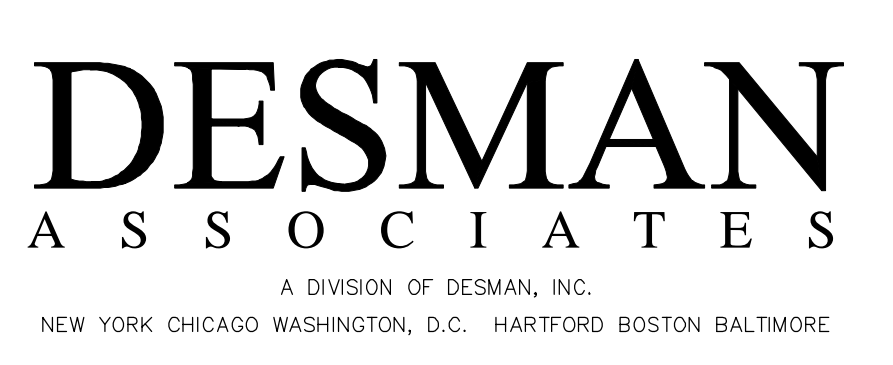

DRAWING NO.		A-2.6R	
SCALE:		AS NOTED	
DATE:	MARCH 2008		
PROJECT NO.:	40-0901.03-2		
DESIGNER:	DRAWN CH'KD.		
DATE:	E.P.G.	W.E.G.	
NO.		DATE	BY
REVISIONS			
DRAWING TITLE		FOURTH LEVEL ROOM NO. PLAN	

Copyright © 2008 Desman, Inc. All rights reserved.
No part of these documents may be reproduced
in any form or by any means without written
permission from Desman, Inc.